


WEST ELEVATION - TO BRIGHTON ROAD

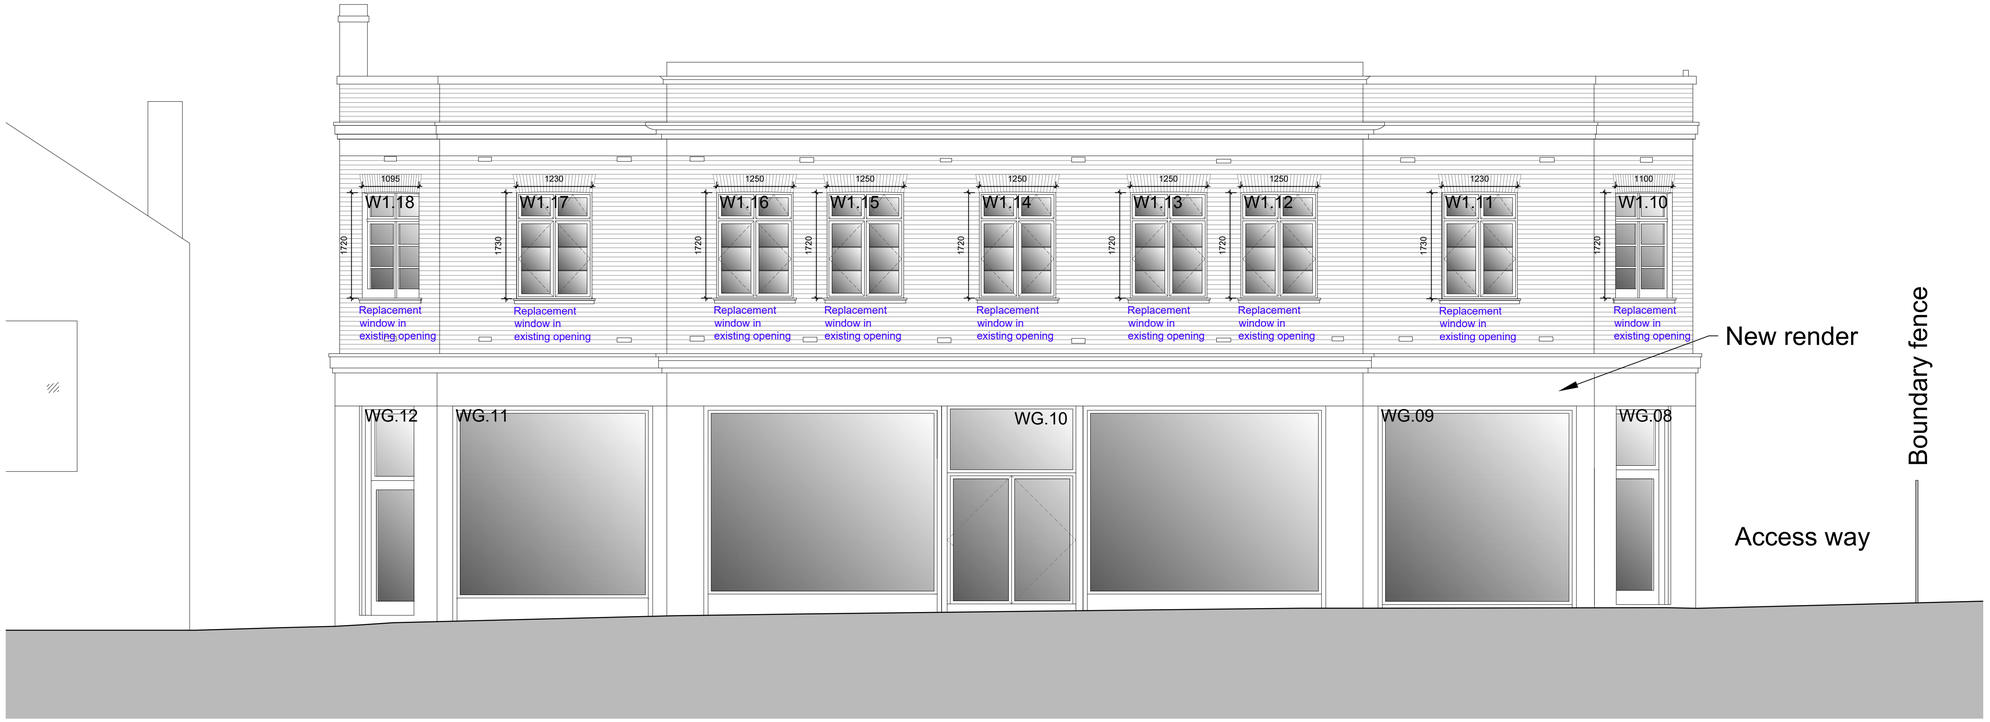

SOUTH ELEVATION

NOTES

1 No dimensions to be scaled from this drawing

2 All dimensions to be checked on site

3 Where discrepancy occurs between specification and drawings the architect must be notified

4 COPYRIGHT The contents of this drawing may not be reproduced in whole or in part without the written permission of Fibonacci-Architects Limited

REVISION

REV	DESCRIPTION	DATE	BY	CKD
A	Record Drawing Issue.	08.04.20	CT	CJL

CDM Regulations 2015 : Regulation 9

In preparing the design shown on this and related drawings Fibonacci-Architects have considered and, where reasonably practicable, avoided foreseeable risks.
Significant risks, which remain, are listed below and identified thus ⚠ and should be given particular attention by all those carrying out works of construction or of future maintenance.

1. **No significant risks.**
2.
3.

None of the above is deemed to relieve any contractor of his obligations under all applicable health and safety legislation.

RECORD DRAWING

PRAETORIAN PROPERTIES
COMMERCIAL PROPERTY DEVELOPERS

FIBONACCI-ARCHITECTS
Milton Heath House : Westcott Road : Dorking : Surrey : RH4 3NB
Tel : 01306 886289 www. fibonacci-architects.co.uk

PROJECT

169 - 173 BRIGHTON ROAD
COULSDON
SURREY CR5 2NH

DRAWING

PROPOSED WEST AND SOUTH ELEVATIONS


DRAWN Chris
CKD CJL
DATE May 2018
SCALE 1:50 @ A1
1:100 @ A3

DRG No 6205 C 07

REVISION A



EAST ELEVATION

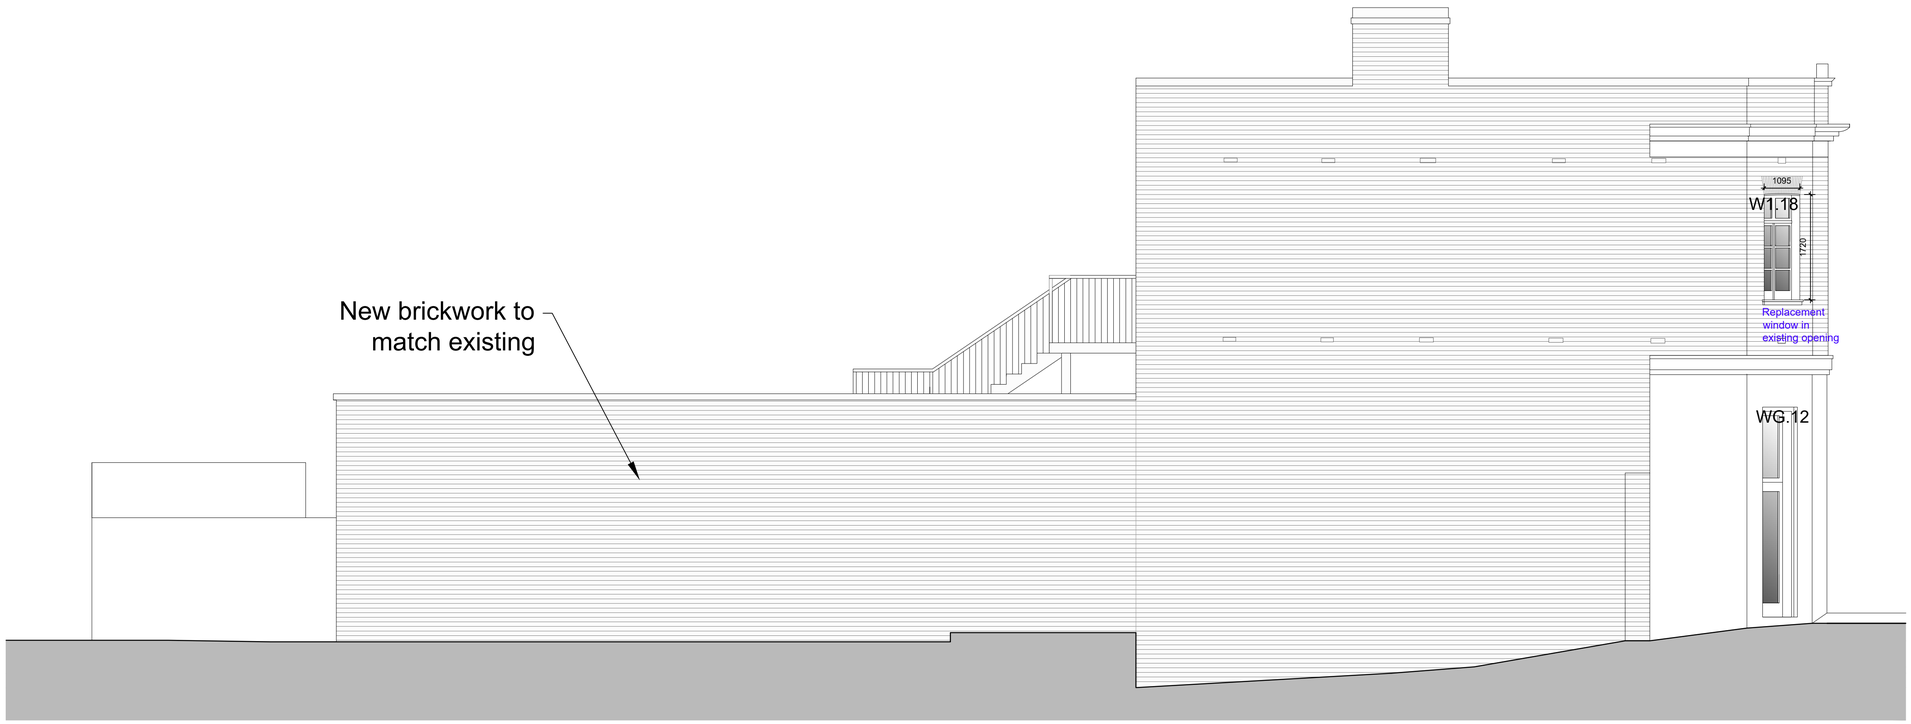

NORTH ELEVATION

NOTES

1. No dimensions to be scaled from this drawing
2. All dimensions to be checked on site
3. Where discrepancy occurs between specification and drawings the architect must be notified
4. COPYRIGHT The contents of this drawing may not be reproduced in whole or in part without the written permission of Fibonacci-Architects Limited

REVISION

REV	DESCRIPTION	DATE	BY	CKD
A	Additional dimensional information added.	10.01.19	CT	CJL
B	Record Drawing Issue.	08.04.20	CT	CJL

CDM Regulations 2015 : Regulation 9

In preparing the design shown on this and related drawings Fibonacci-Architects have considered and, where reasonably practicable, avoided foreseeable risks.
Significant risks, which remain, are listed below and identified thus ⚠ and should be given particular attention by all those carrying out works of construction or of future maintenance.

1. **No significant risks.**
2.
3.

None of the above is deemed to relieve any contractor of his obligations under all applicable health and safety legislation.

RECORD DRAWING

PRAETORIAN PROPERTIES
COMMERCIAL PROPERTY DEVELOPERS

FIBONACCI-ARCHITECTS
Milton Heath House : Westcott Road : Dorking : Surrey : RH4 3NB
Tel : 01306 886289 www. fibonacci-architects.co.uk

PROJECT

169 - 173 BRIGHTON ROAD
COULSDON
SURREY CR5 2NH

DRAWING

PROPOSED EAST AND
NORTH ELEVATIONS

DRAWN	Chris	DRG No	REVISION
CKD	CJL		
DATE	May 2018	6205 C 08	B
SCALE	1:50 @ A1 1:100 @ A3		